

**THE SUNRISE LOFTS**  
 7951 SUNRISE BOULEVARD  
 CITRUS HEIGHTS, CA 95610

**SUNRISE LOFTS DEVELOPMENT, LLC**  
 4120 DOUGLAS BOULEVARD, #306-139  
 GRANITE BAY, CALIFORNIA 95746

**PHA architects**


ARCHITECTS | PLANNERS | CONSULTANTS  
 1730 I street, ste 101  
 sacramento, ca 95814  
 www.pha-arch.com  
 T 916.554.6411  
 F 916.554.6412

**KEYNOTES**

- 101 GUARDRAIL - 36" HIGH MIN
- 102 HANDRAIL - 32"-38" HIGH MIN
- 103 LOWER CABINETS
- 104 UPPER CABINETS
- 105 KITCHEN ISLAND
- 106 FIREPLACE
- 107 TV NICHE ABOVE
- 108 CONCRETE PATIO
- 109 DIRECT VENT FOR FIREPLACE
- 110 TANKLESS WATER HEATER, SMD
- 111 A/C UNIT, SMD
- 112 MECHANICAL UNIT IN ATTIC, SMD  
TRUSS FABRICATOR TO PROVIDE ATTIC TRUSS AS REQUIRED
- 113 CONCRETE FLOOR - STAINED & SEALED

REVISIONS

NO.	DESCRIPTION	DATE
7.		
6.		
5.		
4.		
3.	PLAN CHECK REVISIONS	11/13/06
2.	PLAN CHECK REVISIONS	10/30/06
1.	PLAN CHECK REVISIONS	10/06/06

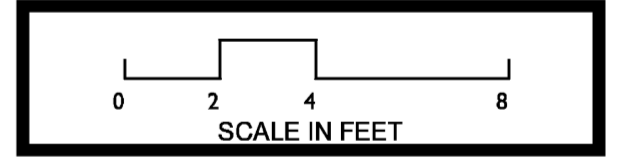

DRAWN: ES  
 SCALE: 1/4" = 1'-0"  
 DATE: 07/12/06  
 JOB NO.: 04046

**UNIT 'C'**


**FLOOR PLANS**

SHEET

**A2.09**



PERMIT RESUBMITTAL - 10/06/06

**KEY PLAN**

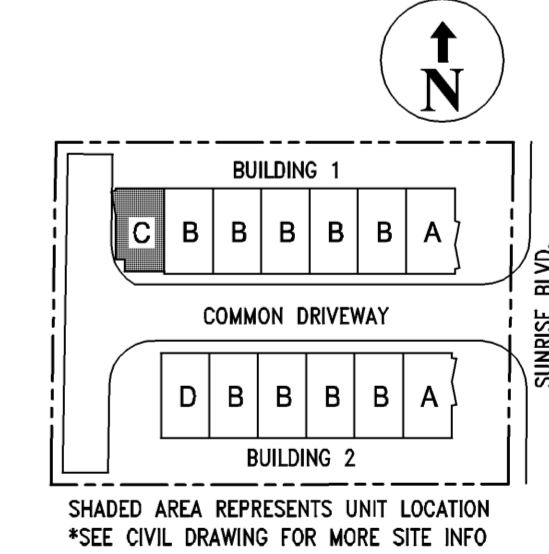

**WALL LEGEND**

- 2X4 FULL HEIGHT WALL
- 2X STAGGERED WALL
- 2X PONY WALL
- 2X6 FULL HEIGHT WALL
- 2X6 - 1-HR. WALL
- 2X6 - 2-HR. WALL

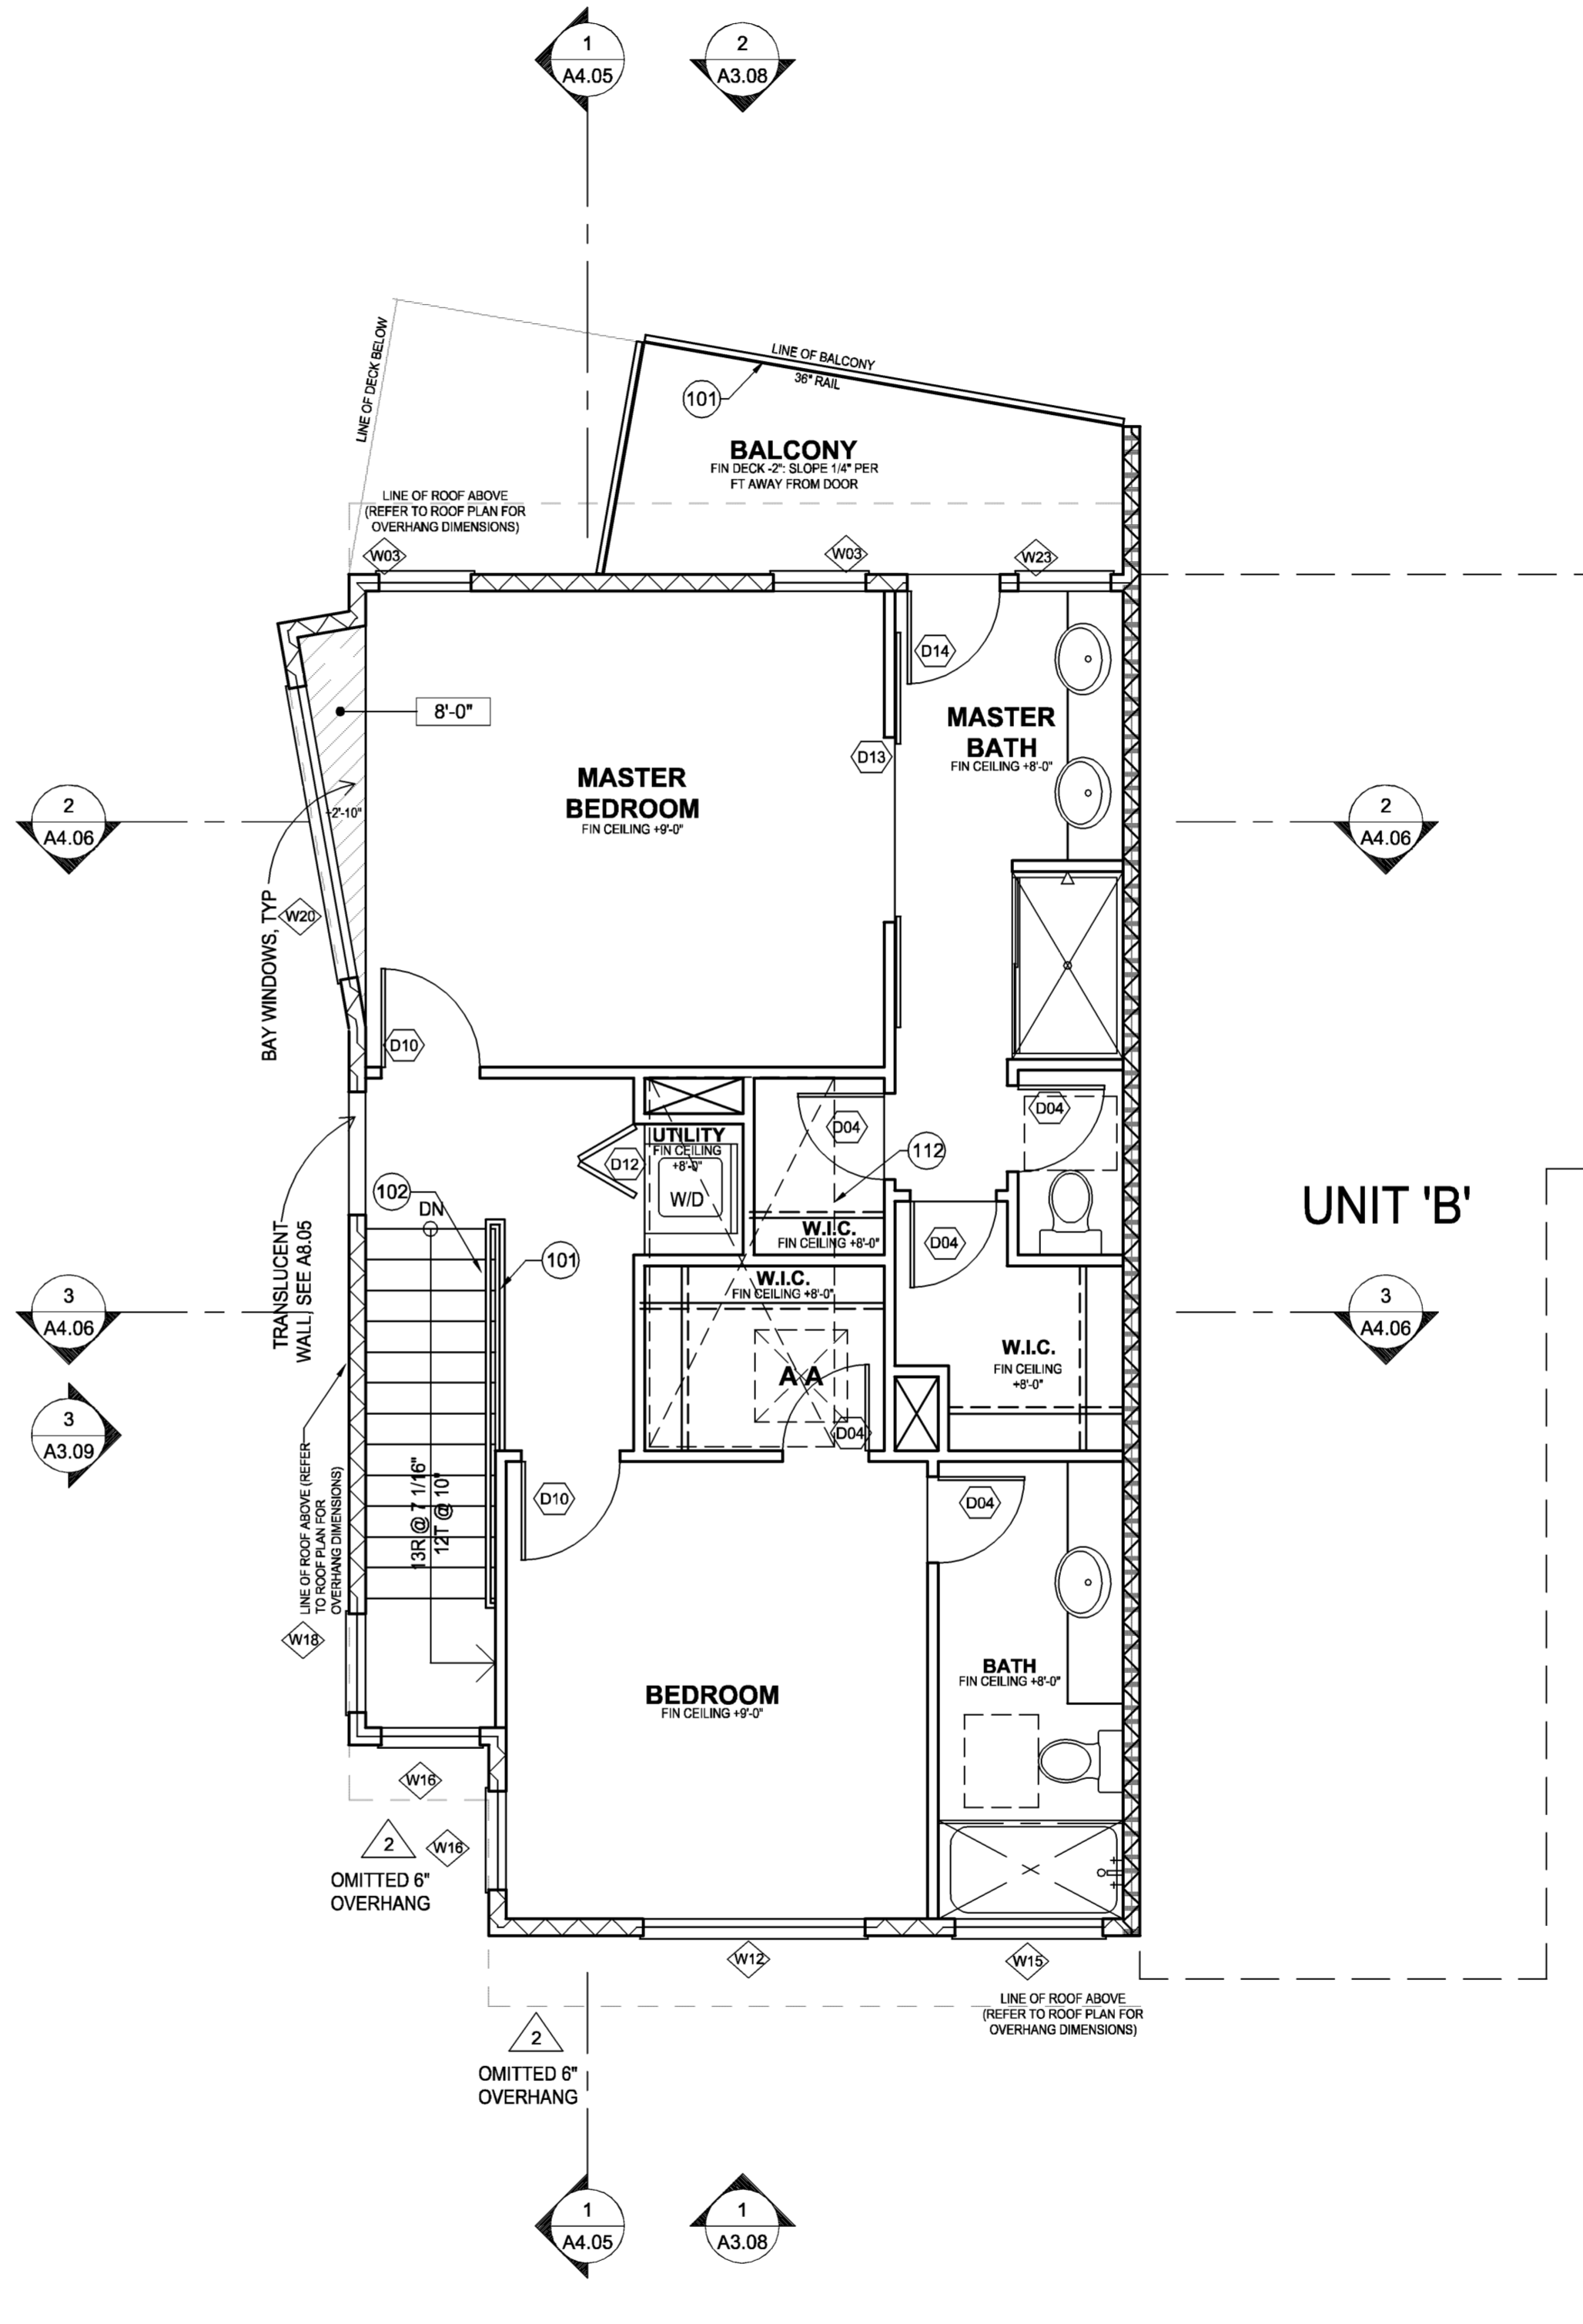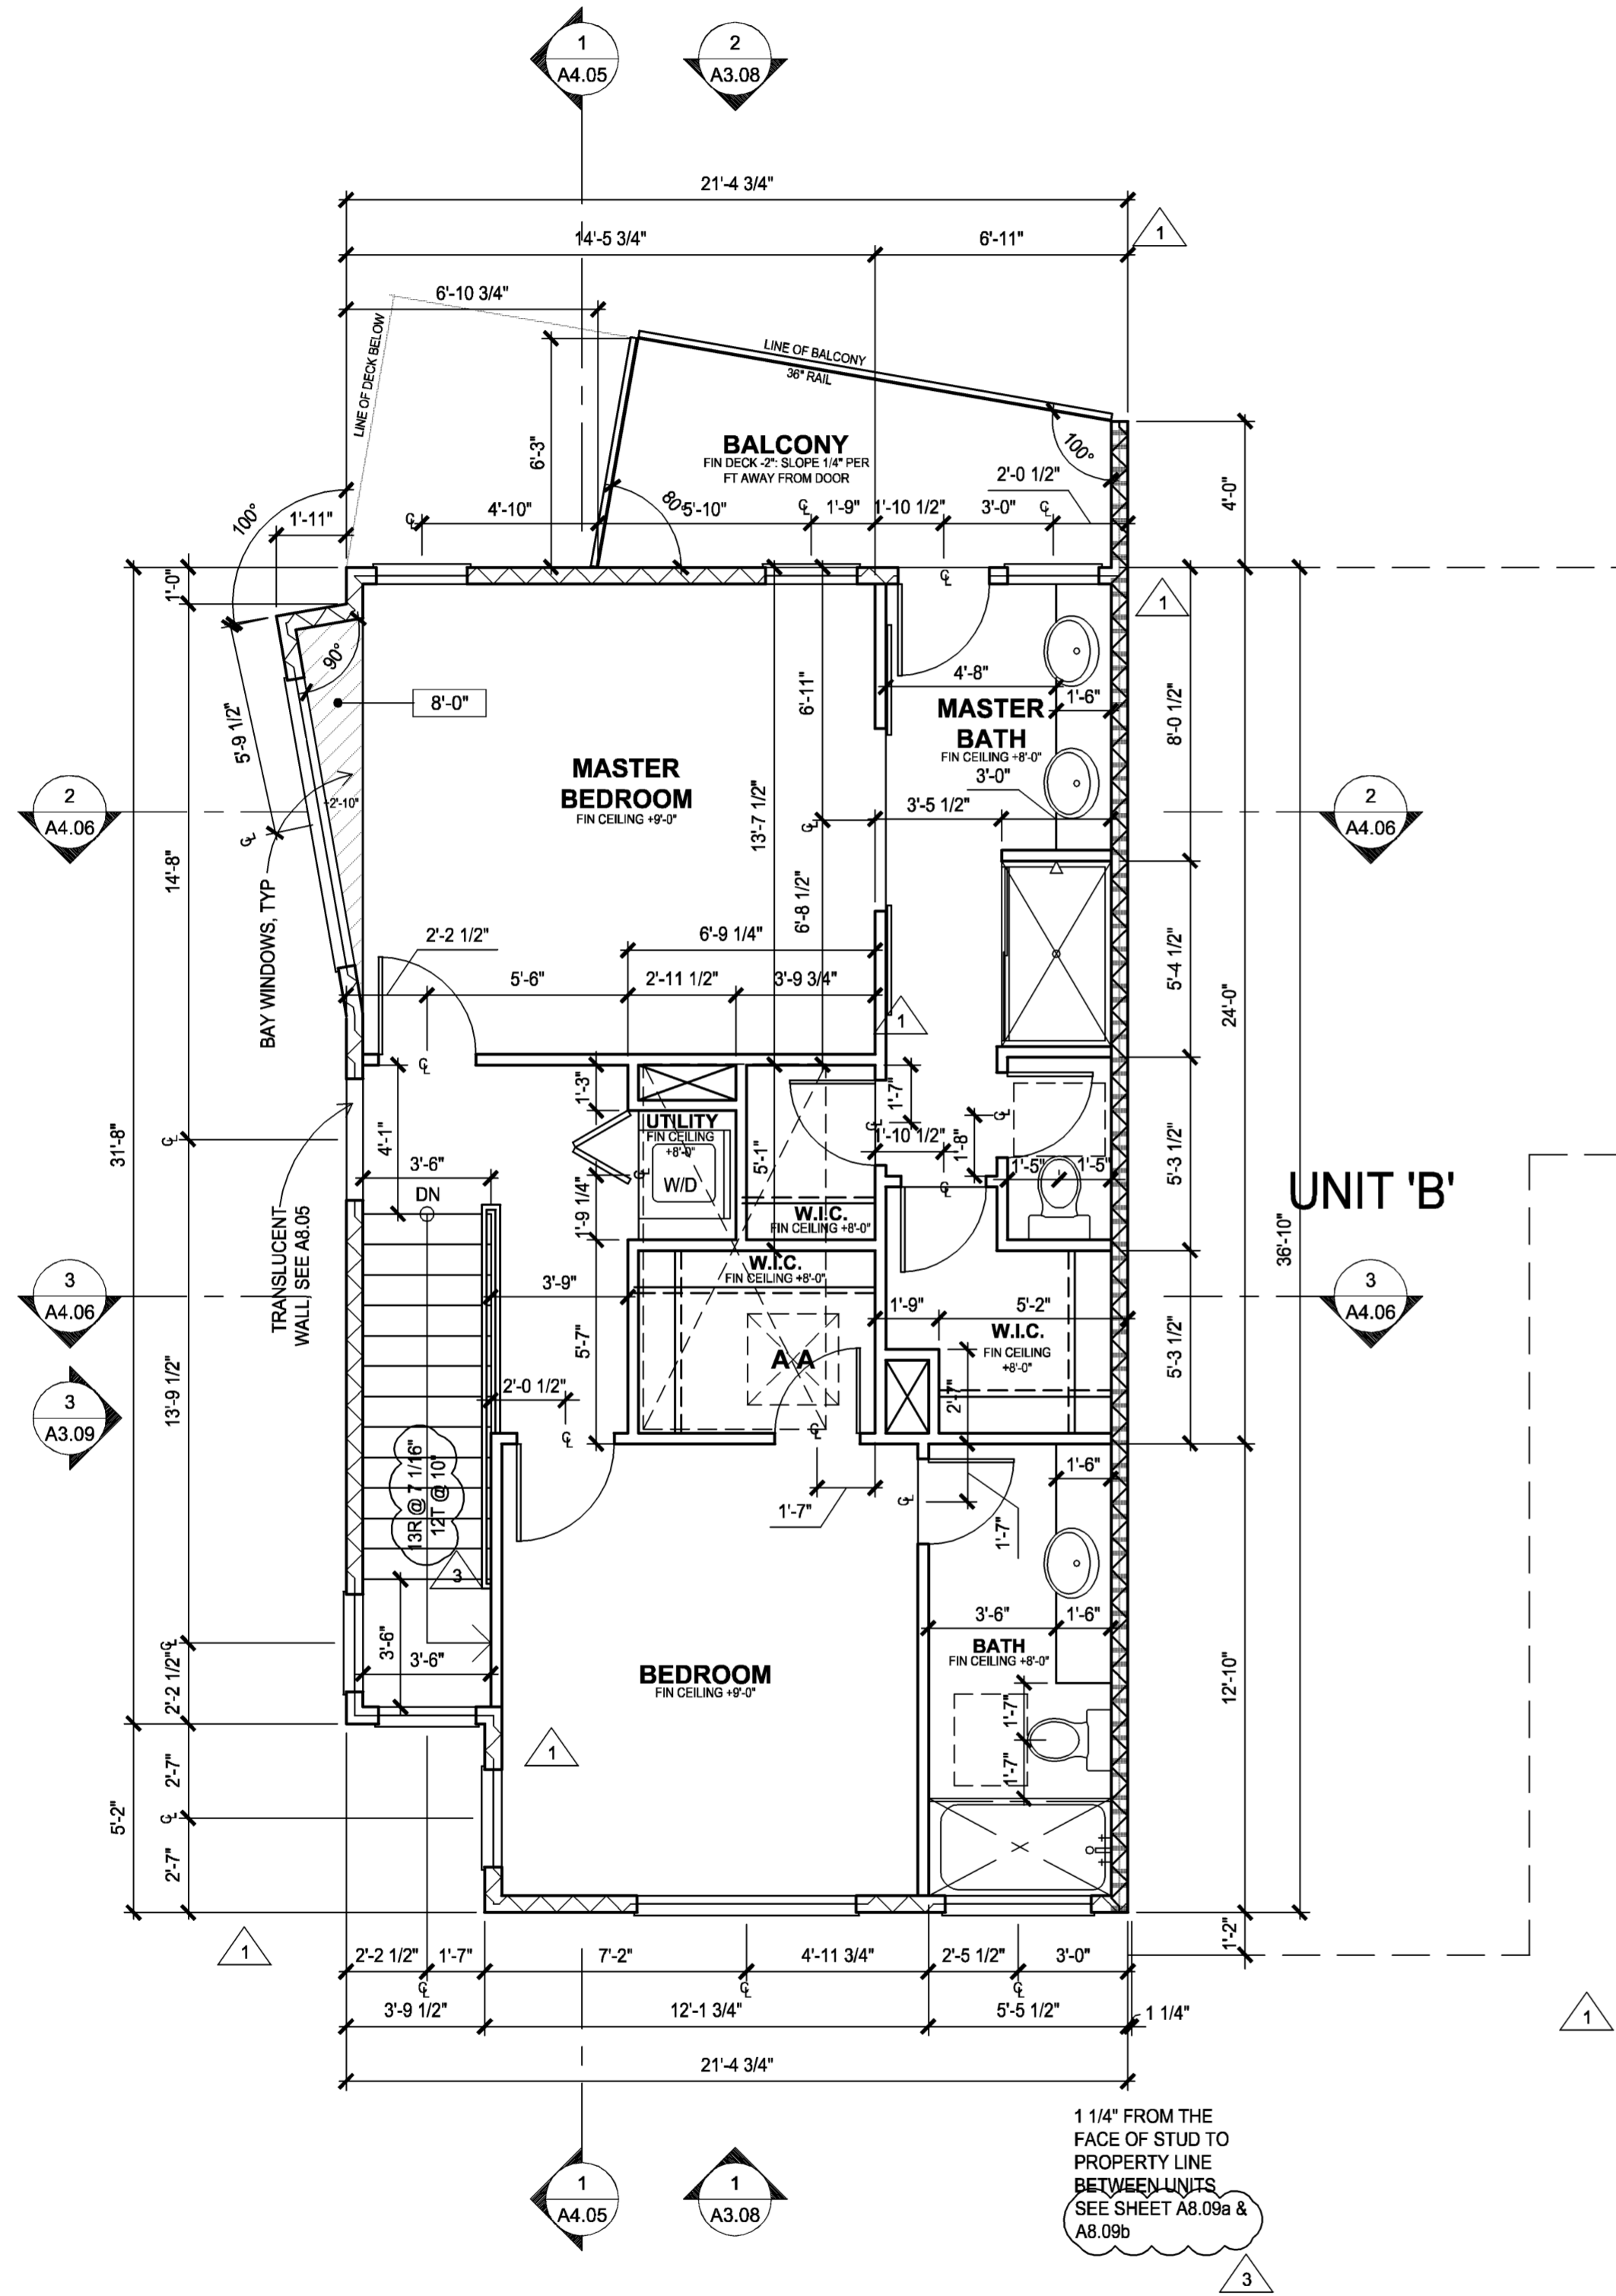

\* REFER TO CIVIL DRAWINGS FOR PROPERTY BOUNDARY

**SEE SHEET A2.09a FOR THIRD FLOOR SQUARE FOOTAGE**

THIRD FLOOR - DIMENSION PLAN

1/4" = 1'-0" **2**

THIRD FLOOR - NOTED PLAN

1/4" = 1'-0" **1**