



COPYRIGHT 2006 PHA, INC. ALL RIGHTS RESERVED

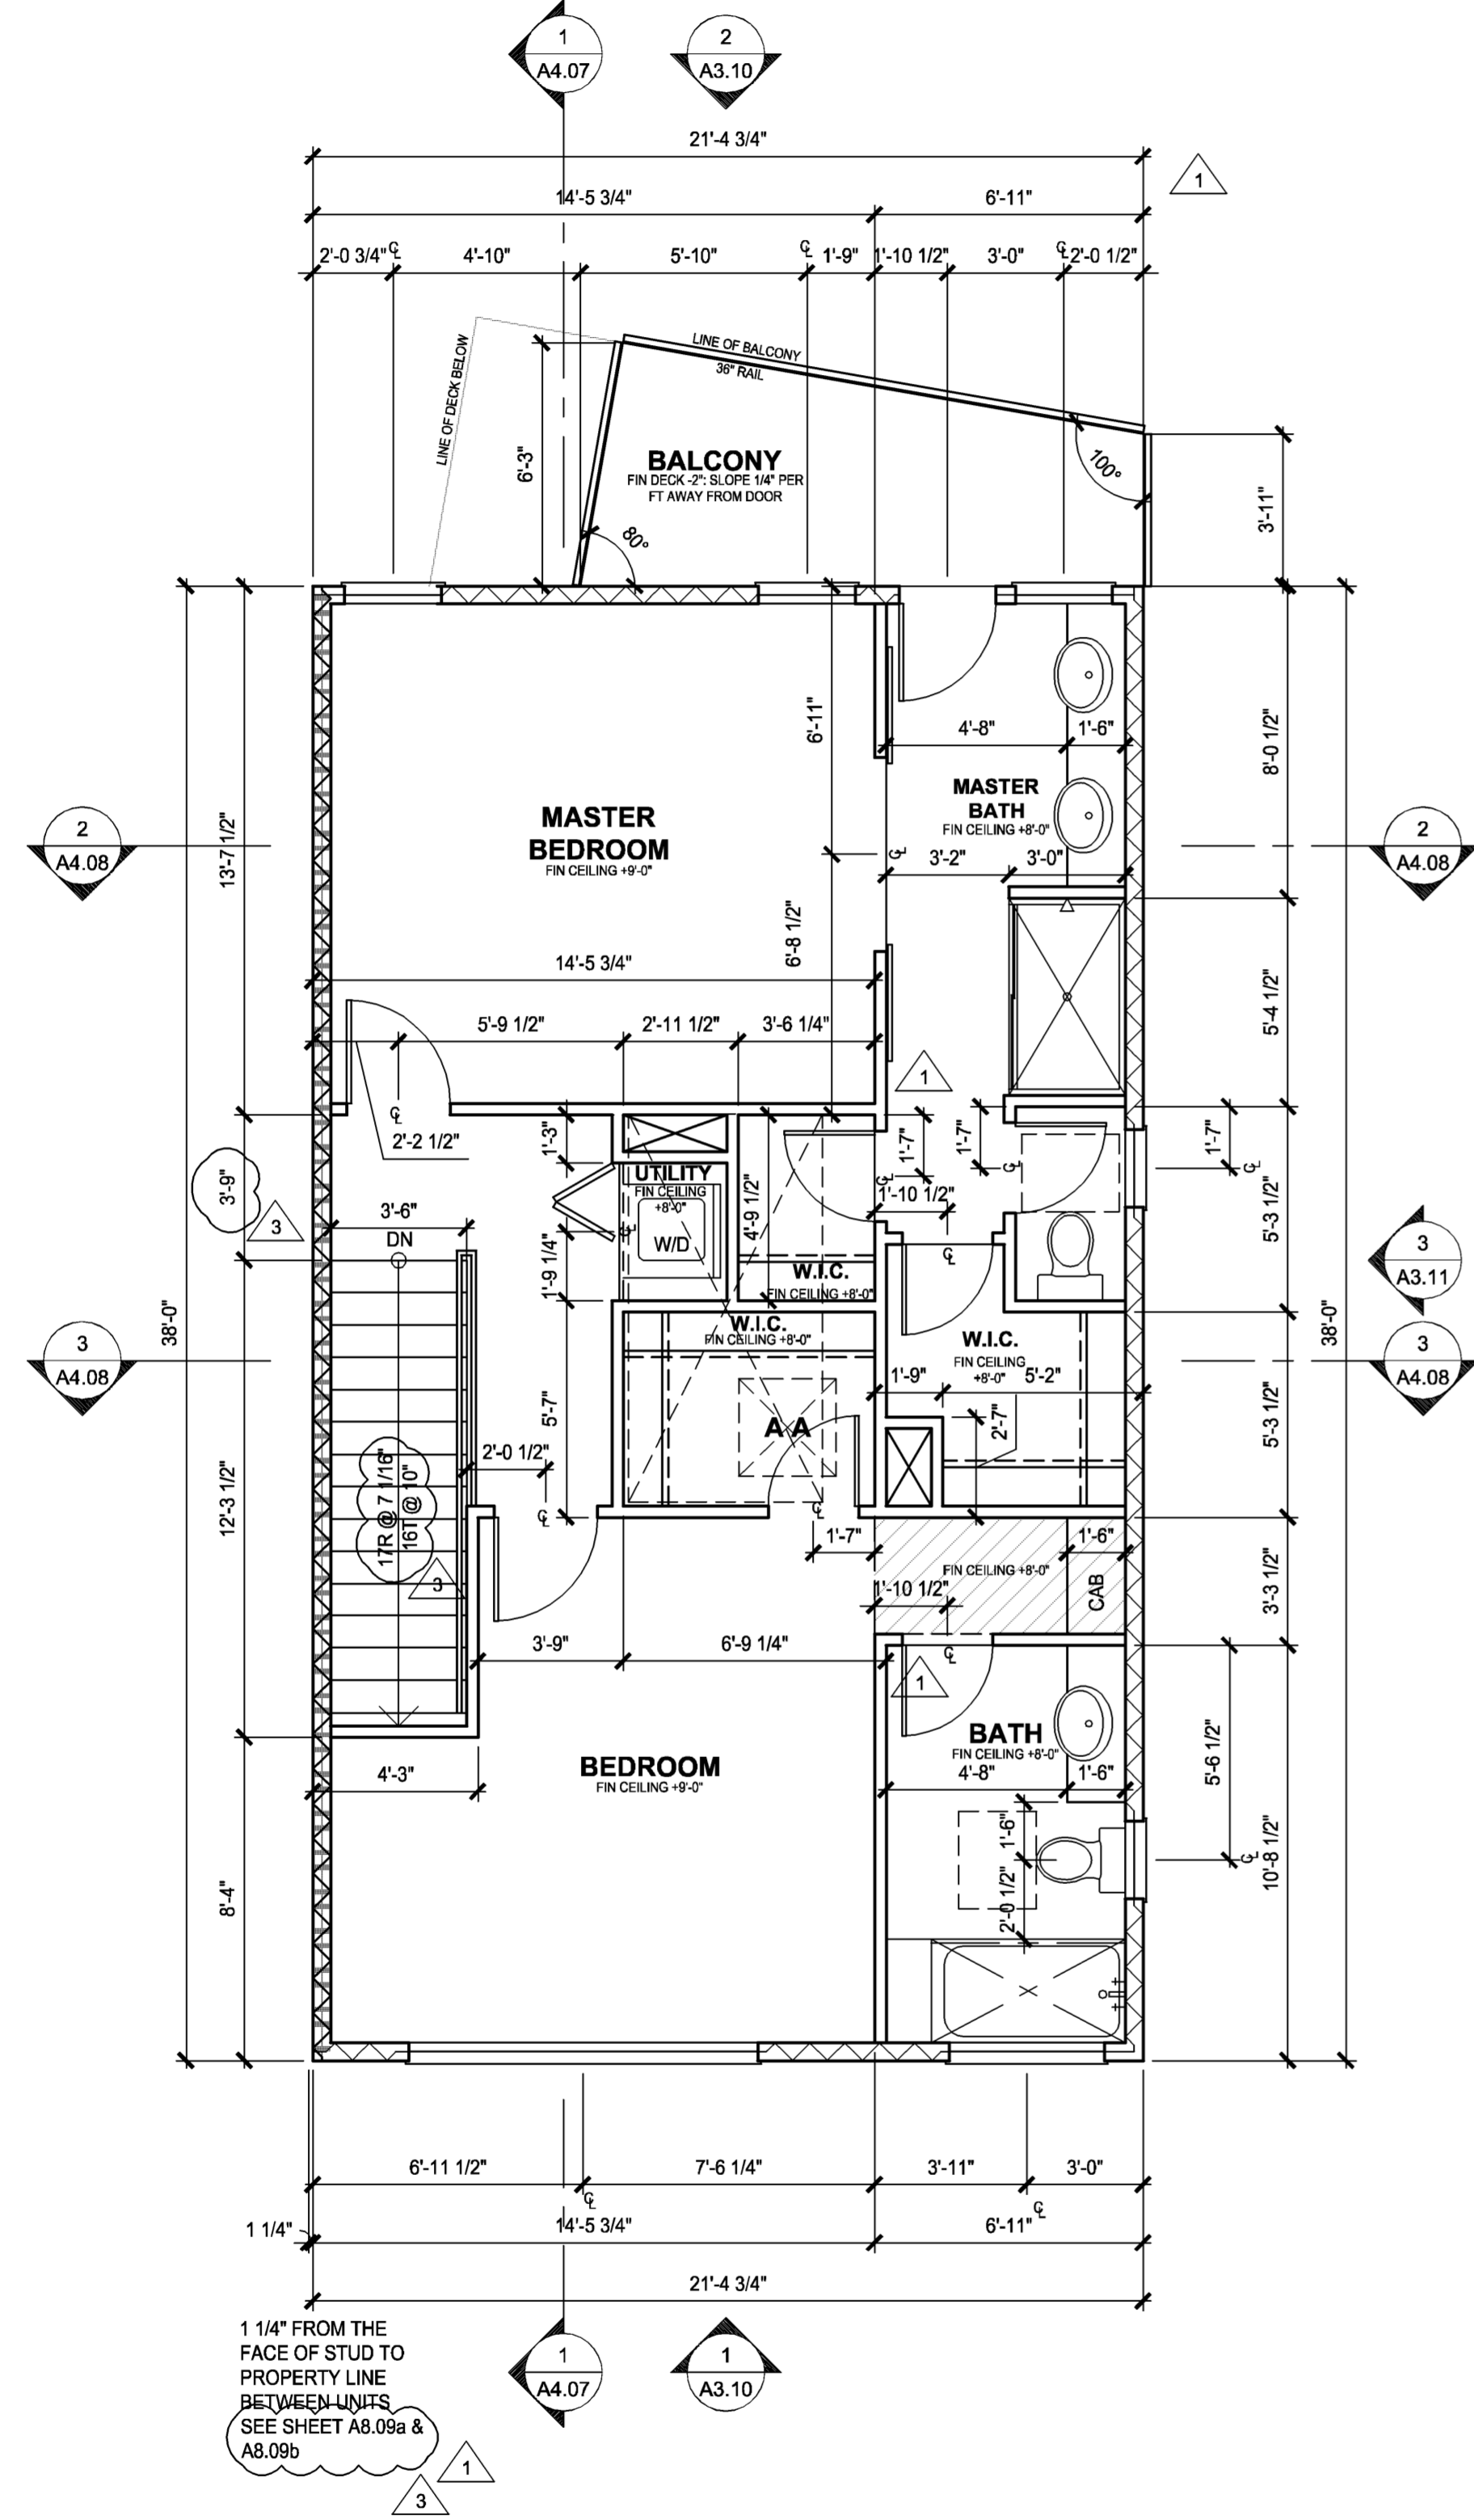

1 1/4" FROM THE FACE OF STUD TO PROPERTY LINE BETWEEN UNITS (SEE SHEET A8.09a & A8.09b)

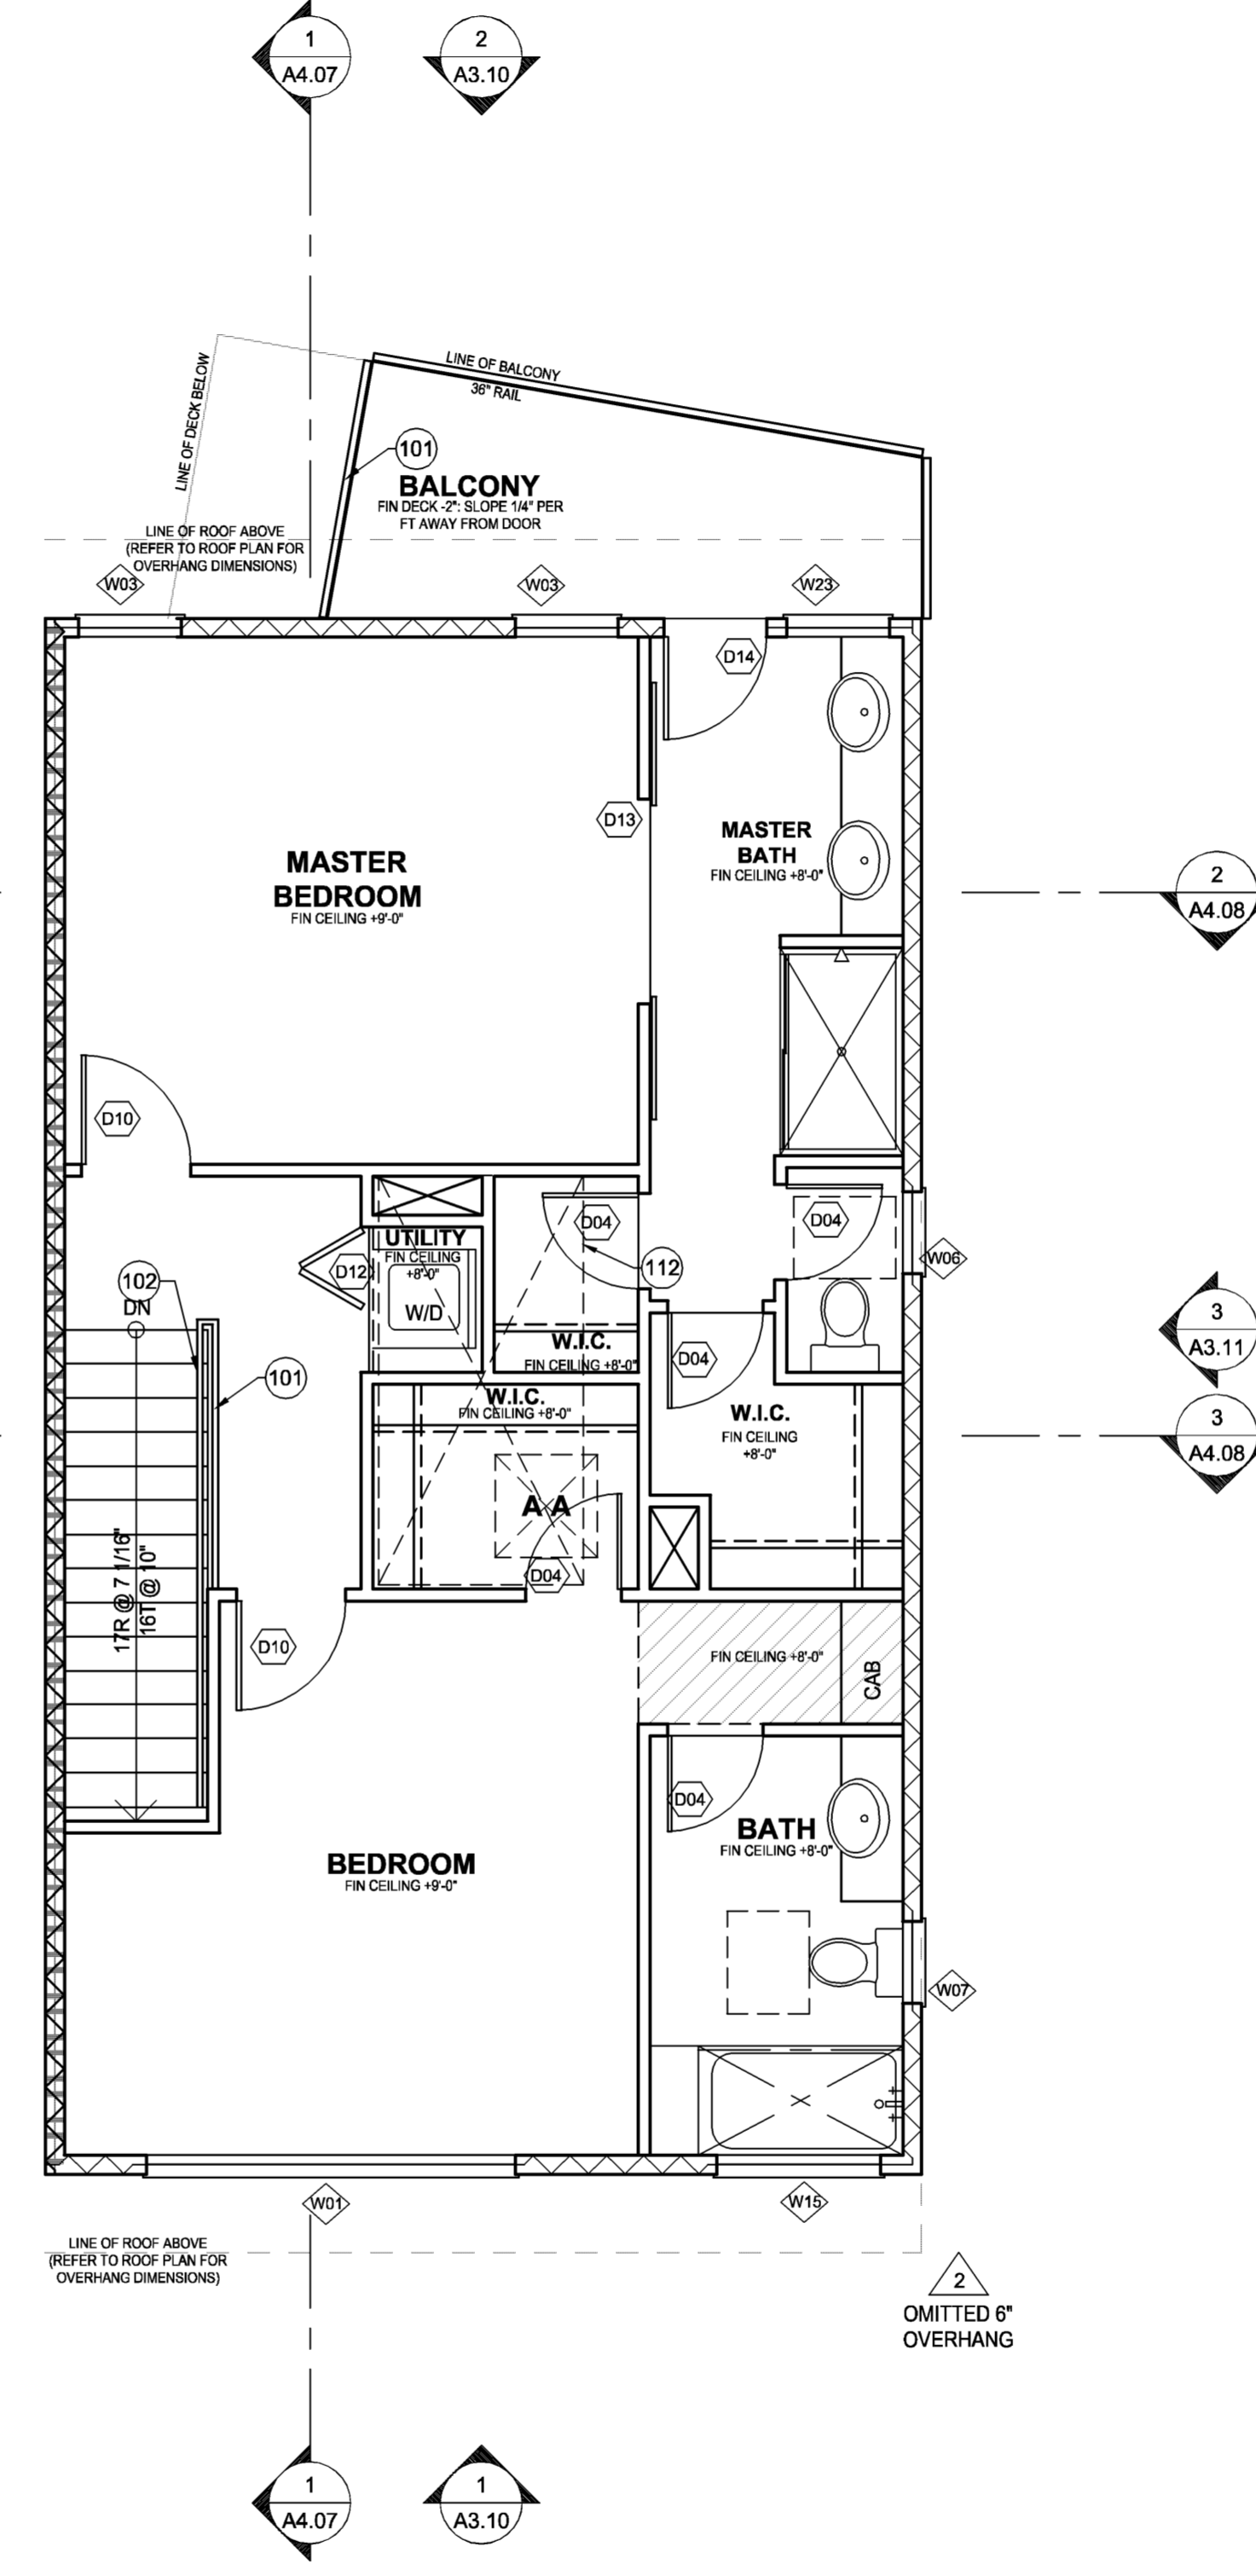


* REFER TO CIVIL DRAWINGS FOR PROPERTY BOUNDARY

SEE SHEET A2.12a FOR THIRD FLOOR SQUARE FOOTAGE

KEYNOTES

- 101 GUARDRAIL - 36" HIGH MIN
- 102 HANDRAIL - 32"-38" HIGH MIN
- 103 LOWER CABINETS
- 104 UPPER CABINETS
- 105 KITCHEN ISLAND
- 106 FIREPLACE
- 107 TV NICHE ABOVE
- 108 CONCRETE PATIO
- 109 DIRECT VENT FOR FIREPLACE
- 110 TANKLESS WATER HEATER, SMD
- 111 A/C UNIT, SMD
- 112 MECHANICAL UNIT IN ATTIC, SMD TRUSS FABRICATOR TO PROVIDE ATTIC TRUSS AS REQUIRED
- 113 CONCRETE FLOOR - STAINED & SEALED

KEY PLAN

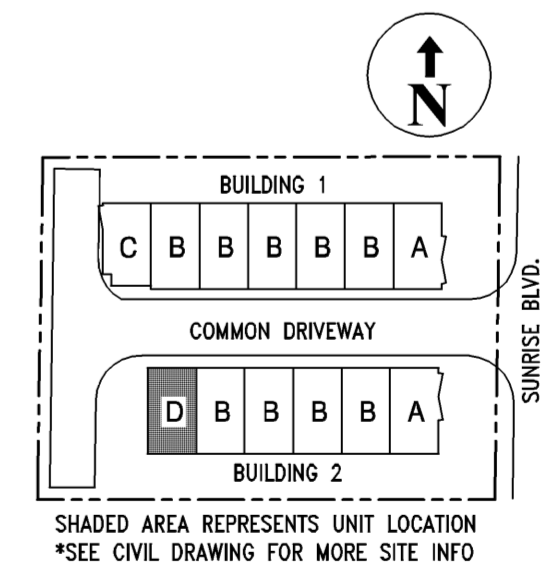

WALL LEGEND

- 2X4 FULL HEIGHT WALL
- 2X STAGGERED WALL
- 2X PONY WALL
- 2X6 FULL HEIGHT WALL
- 2X6 - 1-HR. WALL
- 2X6 - 2-HR. WALL


THE SUNRISE LOFTS
7951 SUNRISE BOULEVARD
CITRUS HEIGHTS, CA 95610

SUNRISE LOFTS DEVELOPMENT, LLC
4120 DOUGLAS BOULEVARD, #306-139
GRANITE BAY, CALIFORNIA 95746

PHA architects

ARCHITECTS | PLANNERS | CONSULTANTS
1730 I street, ste 101
sacramento, ca 95814
www.pha-arch.com

REVISIONS		
NO.	DESCRIPTION	DATE
7.		
6.		
5.		
4.		
3.	PLAN CHECK REVISIONS	11/13/06
2.	PLAN CHECK REVISIONS	10/30/06
1.	PLAN CHECK REVISIONS	10/06/06

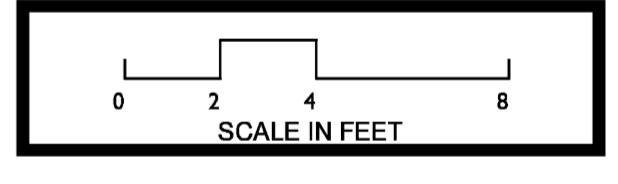

DRAWN: ES
SCALE: 1/4" = 1'-0"
DATE: 07/12/06
JOB NO.: 04046

UNIT 'D'

FLOOR PLANS

SHEET

A2.12

PERMIT RESUBMITTAL - 10/06/06

THIRD FLOOR - DIMENSION PLAN

1/4" = 1'-0" **2**

THIRD FLOOR - NOTED PLAN

1/4" = 1'-0" **1**